

Existing Conditions


Boston, Massachusetts

Project Highlights

As-built documentation helped owners conceptualize space and how to use it.

Space is currently being leased in part due to documentation of space.

Building (right) and details of plans and drawings (below).

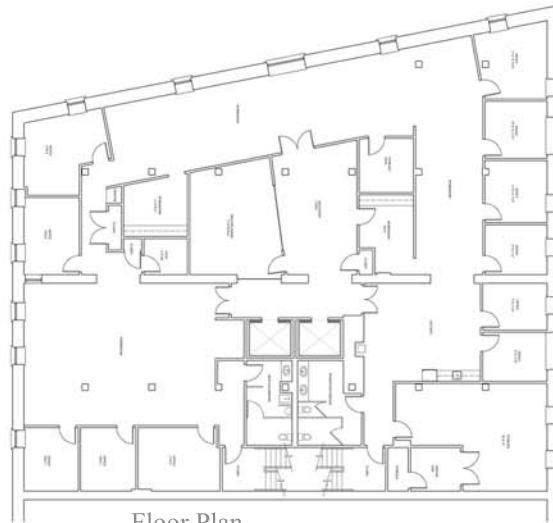

Floor Plan



Details

Your Project, Our Role...

Our firm documented existing conditions for King Design Associates. Their client wanted an as built plan of a building in Boston.

Our firm developed drawings from start to finish for the project. Everything from measuring the space through drafting was completed in short order to meet the clients needs.

The Preservation Collaborative can develop as built drawings for your building. No matter if it is a small project or a large redevelopment, we can assist with all phases of work.

Contact us today to get started!

